


4.8. Driveway & Parking 85.0 m<sup>2</sup>



2.6 Garage / Laundry 19.6 m<sup>2</sup>

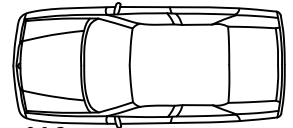

4.5 Outdoor dining 25.0 m<sup>2</sup>


BBO




4.10 Garden 1

60 m<sup>2</sup>


4.7. Circulation 2 15.0 m<sup>2</sup>

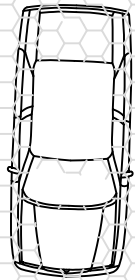


2.1 entrance hall 13.2 m<sup>2</sup>

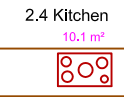

2.4 Kitchen 10.1 m<sup>2</sup>

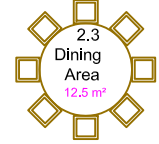


2.3 Dining Area 12.5 m<sup>2</sup>

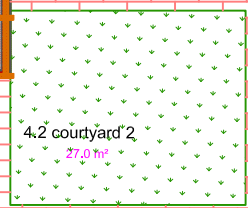


4.2 courtyard 2 27.0 m<sup>2</sup>

2.8 LIFT 1.44 m<sup>2</sup>

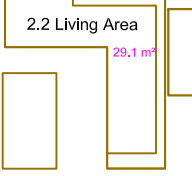

2.2 Living Area 29.1 m<sup>2</sup>

desk

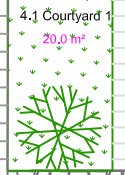


4.1 Courtyard 1 20.0 m<sup>2</sup>

4.6. Circulation 1 18.0 m<sup>2</sup>



Shower

4.3. Ground floor veranda 40.0 m<sup>2</sup>

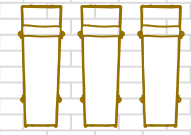

4.4. Pool-side Area 46.0 m<sup>2</sup>

Solar Panels

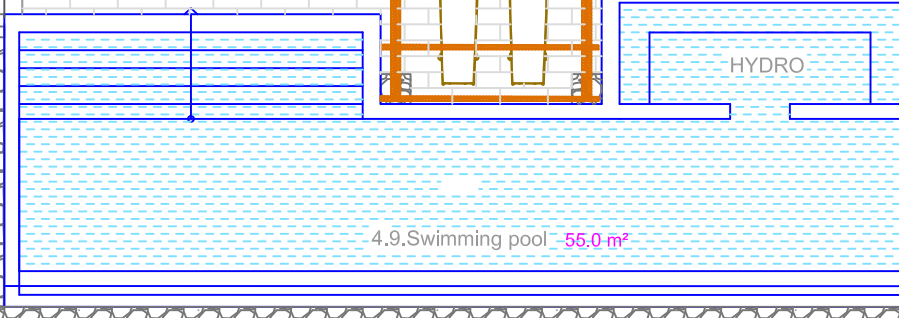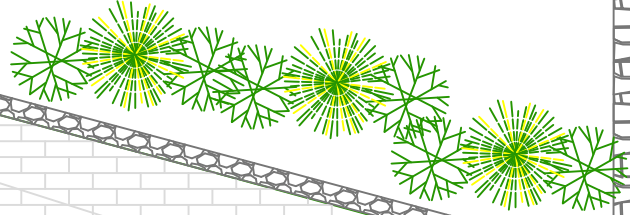

4.9. Swimming pool 55.0 m<sup>2</sup>

HYDRO

630 m<sup>2</sup>  
4.13 TENNIS

4.11: Garden 2 300 m<sup>2</sup>